


AS BUILT (without Front extension)
SIDE ELEVATION-B

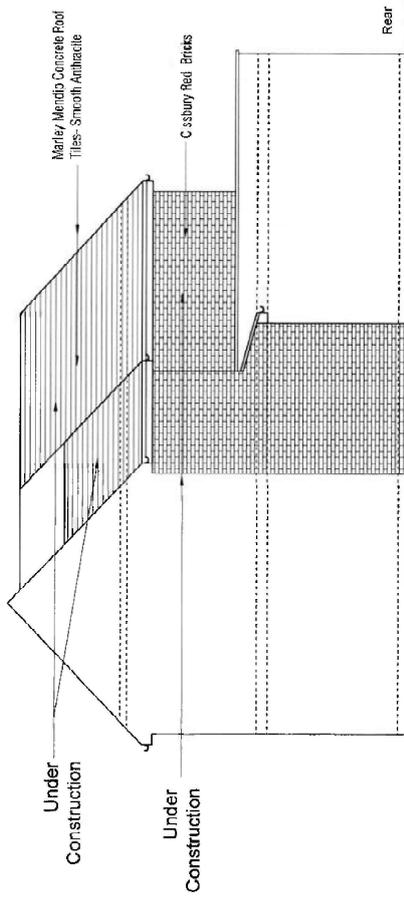

AS BUILT (without Front extension)
SIDE ELEVATION-A

Rev.B Material info provided .
(19/08/25)- SB

Rev.A Front extension removed &
annotations changed. (21/07/25)- SB

1:5 = 25cm	1:200 = 1.0m
1:10 = 50cm	1:250 = 12.5m
1:20 = 100cm	1:500 = 25m
1:50 = 2.5m	1:1250 = 62.5m
1:100 = 5m	1:2500 = 125m

Copyright Z.S. Partnership Ltd (2024)

PLANNING ISSUE

ZSP
ZS Partnership Ltd.
Architectural Design & Planning
468 Conventry Road, Small Heath
Birmingham B10 0TU
0121 772 4096

Drawing Title:
Proposed Front and Side Elevations

Proposal:
Retention of Single Storey/Part Two Storey Rear Extensions

Project Location:
**7 Limes Avenue, Rowley Regis
West Midlands B65 8AZ**


Scale: 1/100 @ A3
Drawn: Ash/RA

Drawing No:
ZL5531/5

Date:
19/06/25

Amendments
T A

Note: This drawing to be read in
Conjunction with Cdg No Z. 553/4

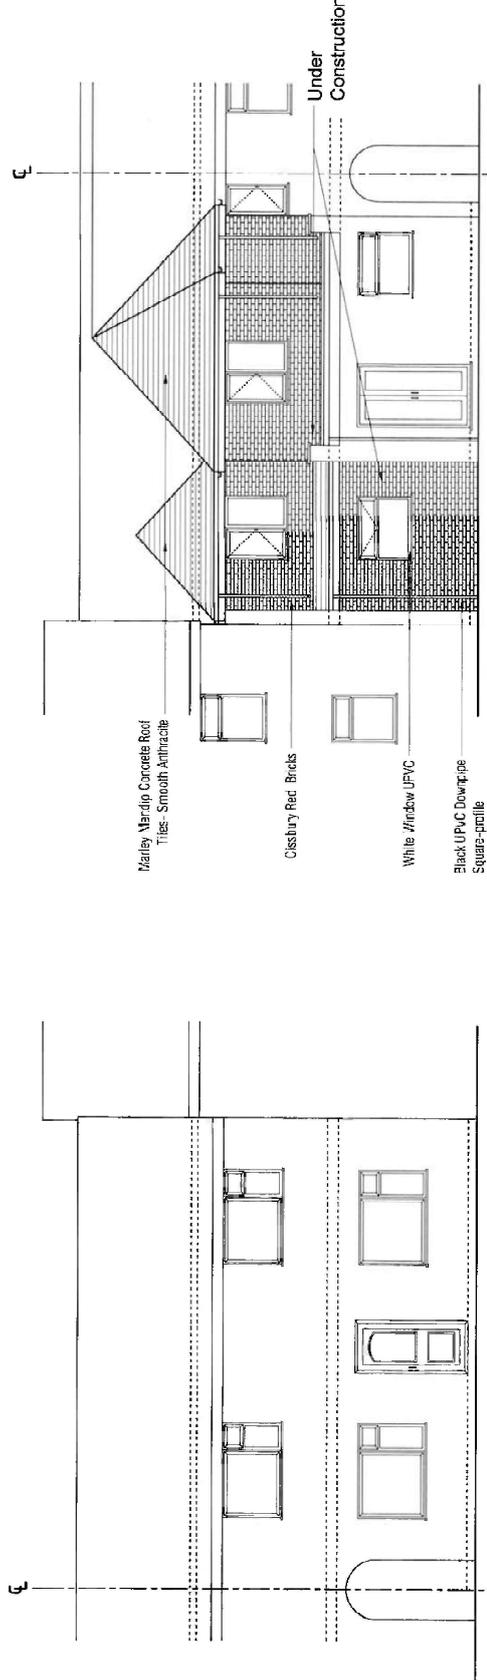

AS BUILT (without Front extension)
REAR ELEVATION

AS BUILT (without Front extension)
FRONT ELEVATION