



Note: no plan has been produced for the first and second floors as there have been no changes to these areas


EAST VIEW

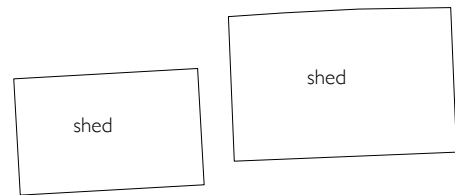

Roof Plan - Existing (pre construction)

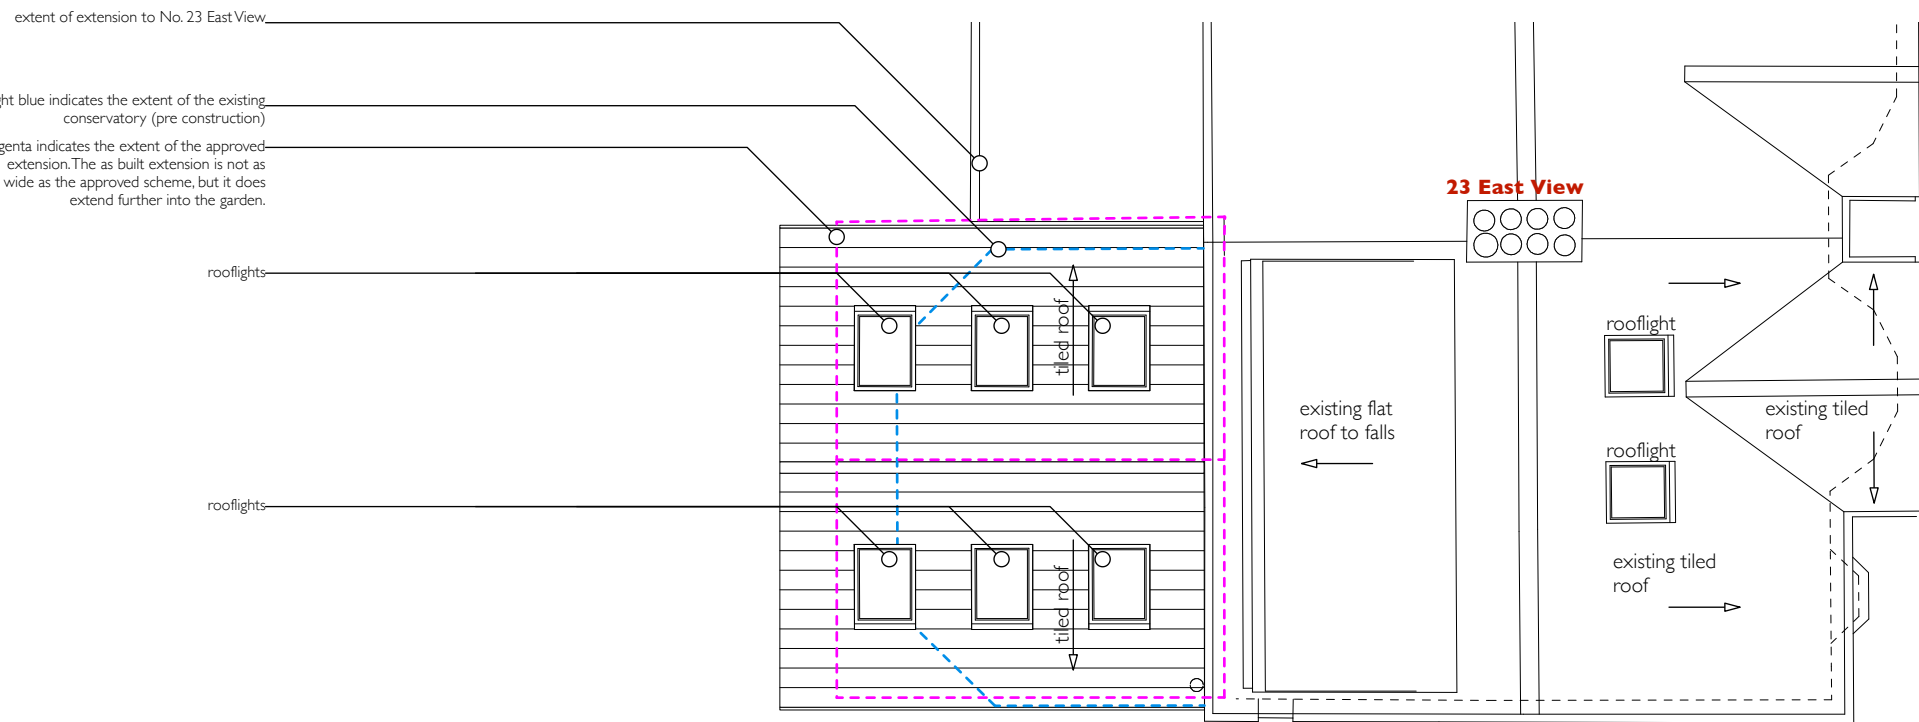

EAST VIEW

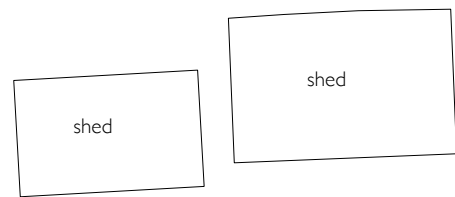

Roof Plan - As Built



Rev		Date
P2	PLANNING Issue	16.03.2026
P1	PLANNING Issue	14.03.2026

James Pooley
architecture

james@jamespooleyarchitecture.com 55 Goring Road N11 2BT
www.jamespooleyarchitecture.com 07881 585857

EVI: Ground Floor Extension
21 East View, London, E4 9JA

Existing (Original) and As Built Roof Plan
scale: 1:100 @A3 Date: MARCH 2026 Drawn by: JP

EVI-005

P2