





South Elevation - Existing (Pre Construction)

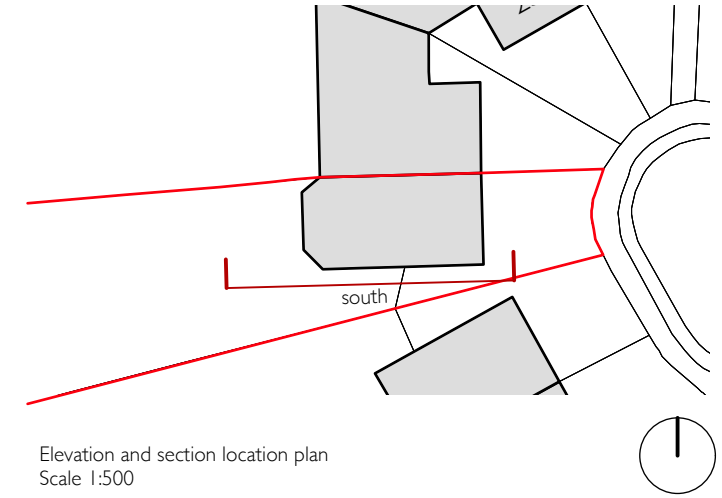

Elevation and section location plan
Scale 1:500

Materials

- 1** - existing yellow stock brick masonry walls with red brick detailing
- 2** - existing cement render to bay window and gable
- 3** - existing tiled roof
- 4** - existing conservatory
- 5** - existing painted timber and glazed door
- 6** - existing timber fence
- 7** - existing UPVC framed double glazed windows
- 8** - existing rooflights
- 9** - existing tiles to dormer walls and cheeks
- 10** - Aluminium framed double glazed bifolding door
- 11** - aluminium framed double glazed windows
- 12** - yellow brick masonry wall with red brick detailing
- 13** - tiled roof
- 14** - rooflights
- 15** - metal balustrade to terrace

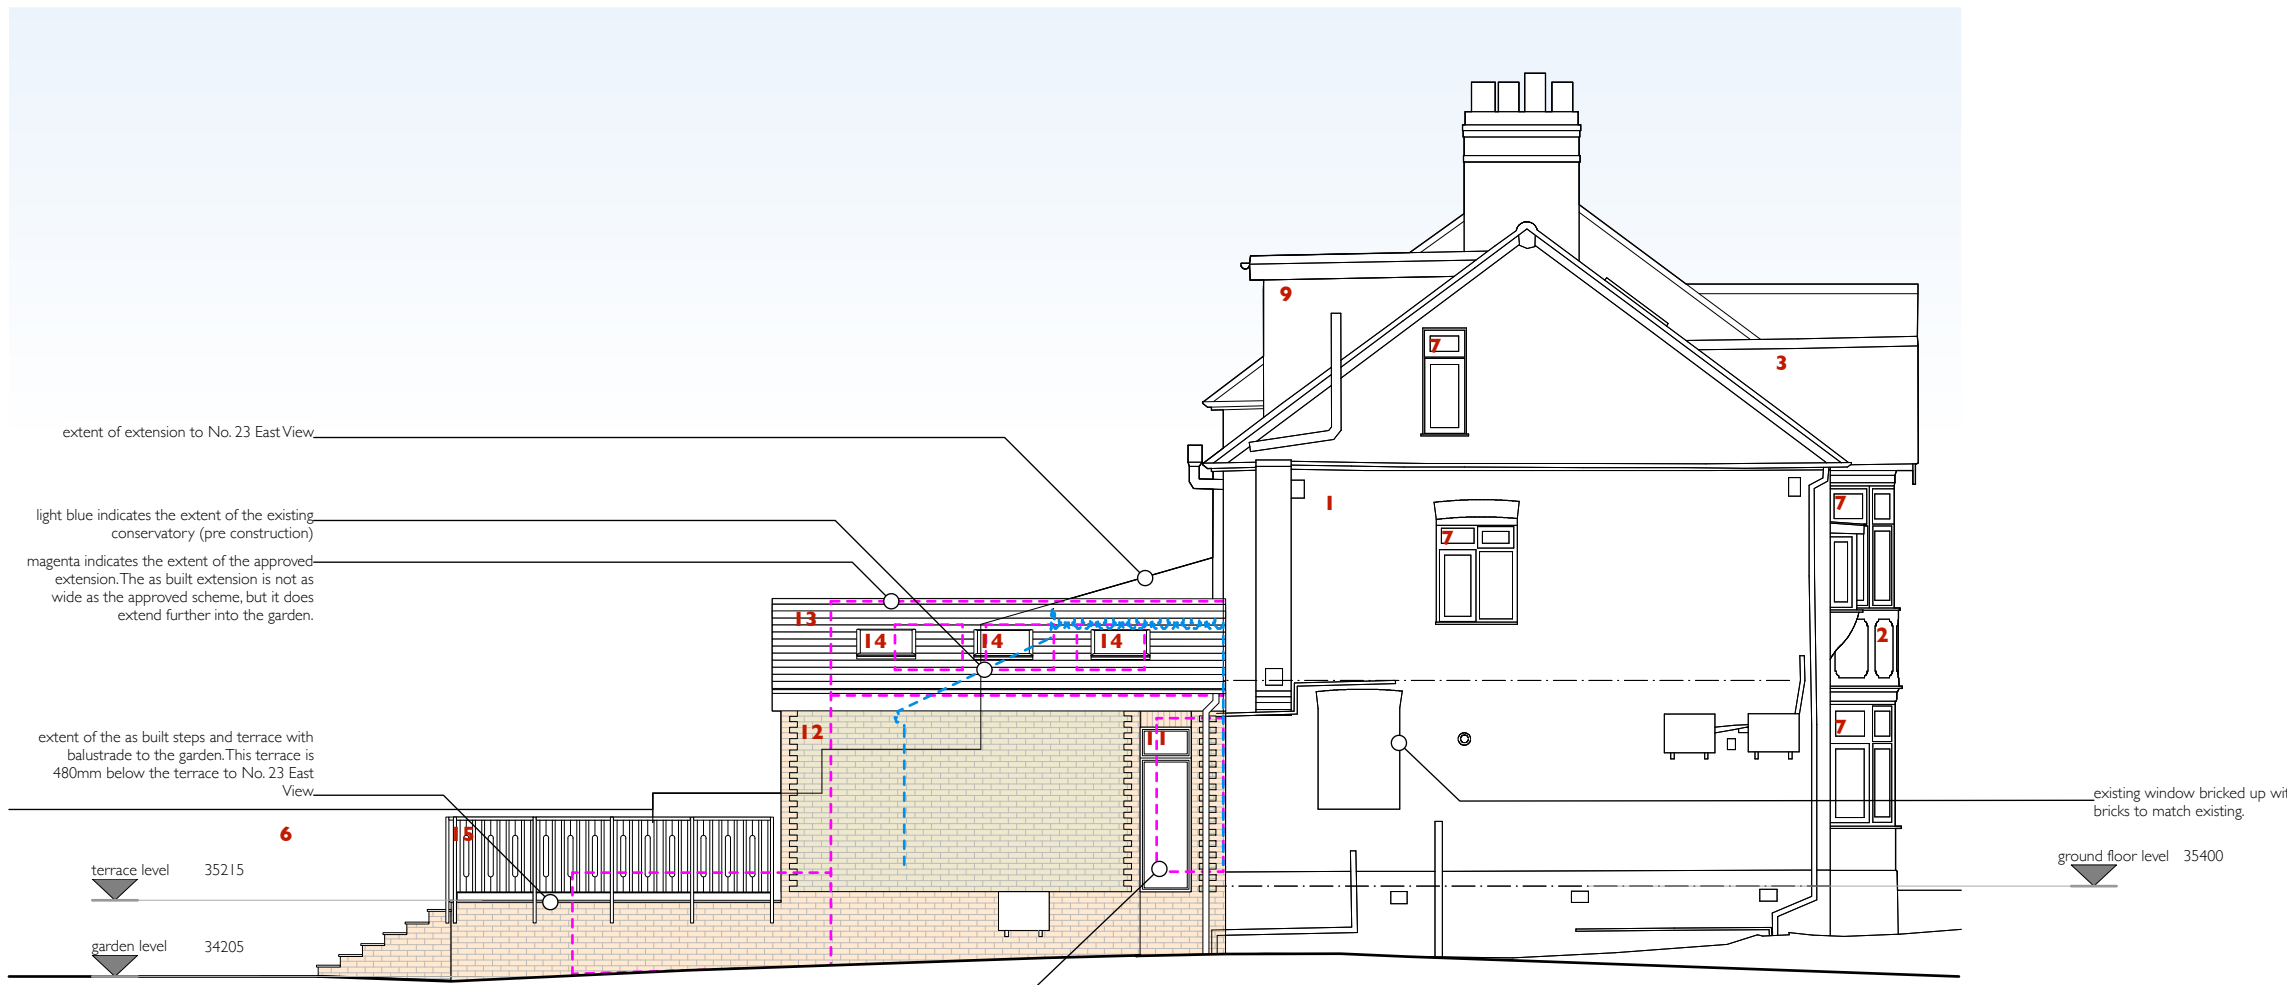

South Elevation - As Built

extent of the approved window. The as built window is narrower

| | | |
|-----|----------------|------------|
| Rev | | Date |
| P2 | PLANNING Issue | 16.03.2026 |
| P1 | PLANNING Issue | 14.03.2026 |

James Pooley
architecture

james@jamespooleyarchitecture.com 55 Goring Road N11 2BT
www.jamespooleyarchitecture.com 07881 585857

EVI: Ground Floor Extension
21 East View, London, E4 9JA
Existing (Original) and As Built S Elevations

scale: 1:100 @ A3 Date: MARCH 2026 Drawn by: JP

EVI-008

P2

