



Elevation and section location plan
Scale 1:500

- Materials**
- 1** - existing yellow stock brick masonry walls with red brick detailing
 - 2** - existing cement render to bay window and gable
 - 3** - existing tiled roof
 - 4** - existing conservatory
 - 5** - existing painted timber and glazed door
 - 6** - existing timber fence
 - 7** - existing UPVC framed double glazed windows
 - 8** - existing rooflights
 - 9** - existing tiles to dormer walls and cheeks
 - 10** - Aluminium framed double glazed bifolding door
 - 11** - aluminium framed double glazed windows
 - 12** - yellow brick masonry wall with red brick detailing
 - 13** - tiled roof
 - 14** - rooflights
 - 15** - metal balustrade to terrace

Section AA - Existing (Pre Construction)

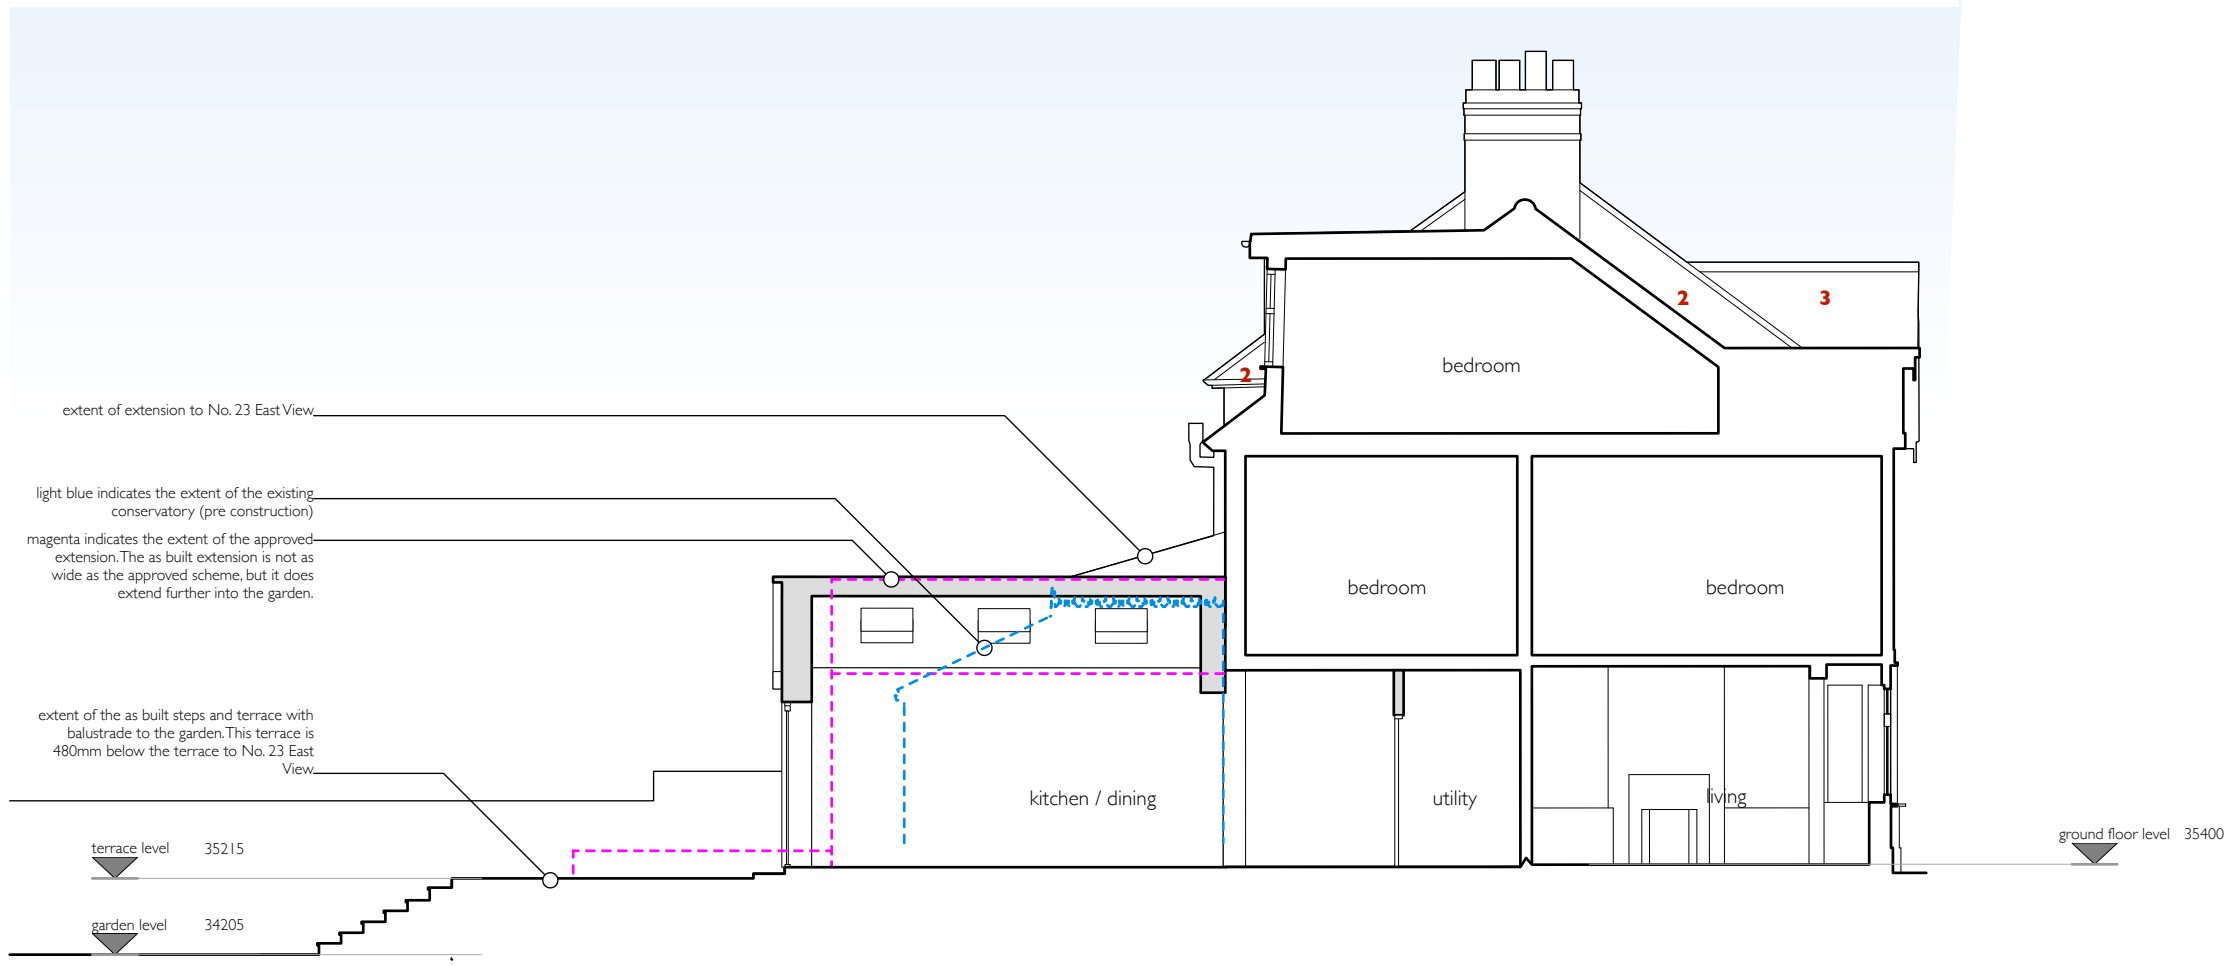

Section AA - As Built

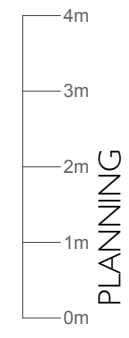

Rev P1 PLANNING Issue Date 16.03.2026

James Pooley
architecture

james@jamespooleyarchitecture.com 55 Goring Road N11 2BT
www.jamespooleyarchitecture.com 07881 585857

EVI: Ground Floor Extension
21 East View, London, E4 9JA
Existing (Original) and As Built Sections

scale: 1:100 @ A3 Date: MARCH 2026 Drawn by: JP

EVI-009

PI